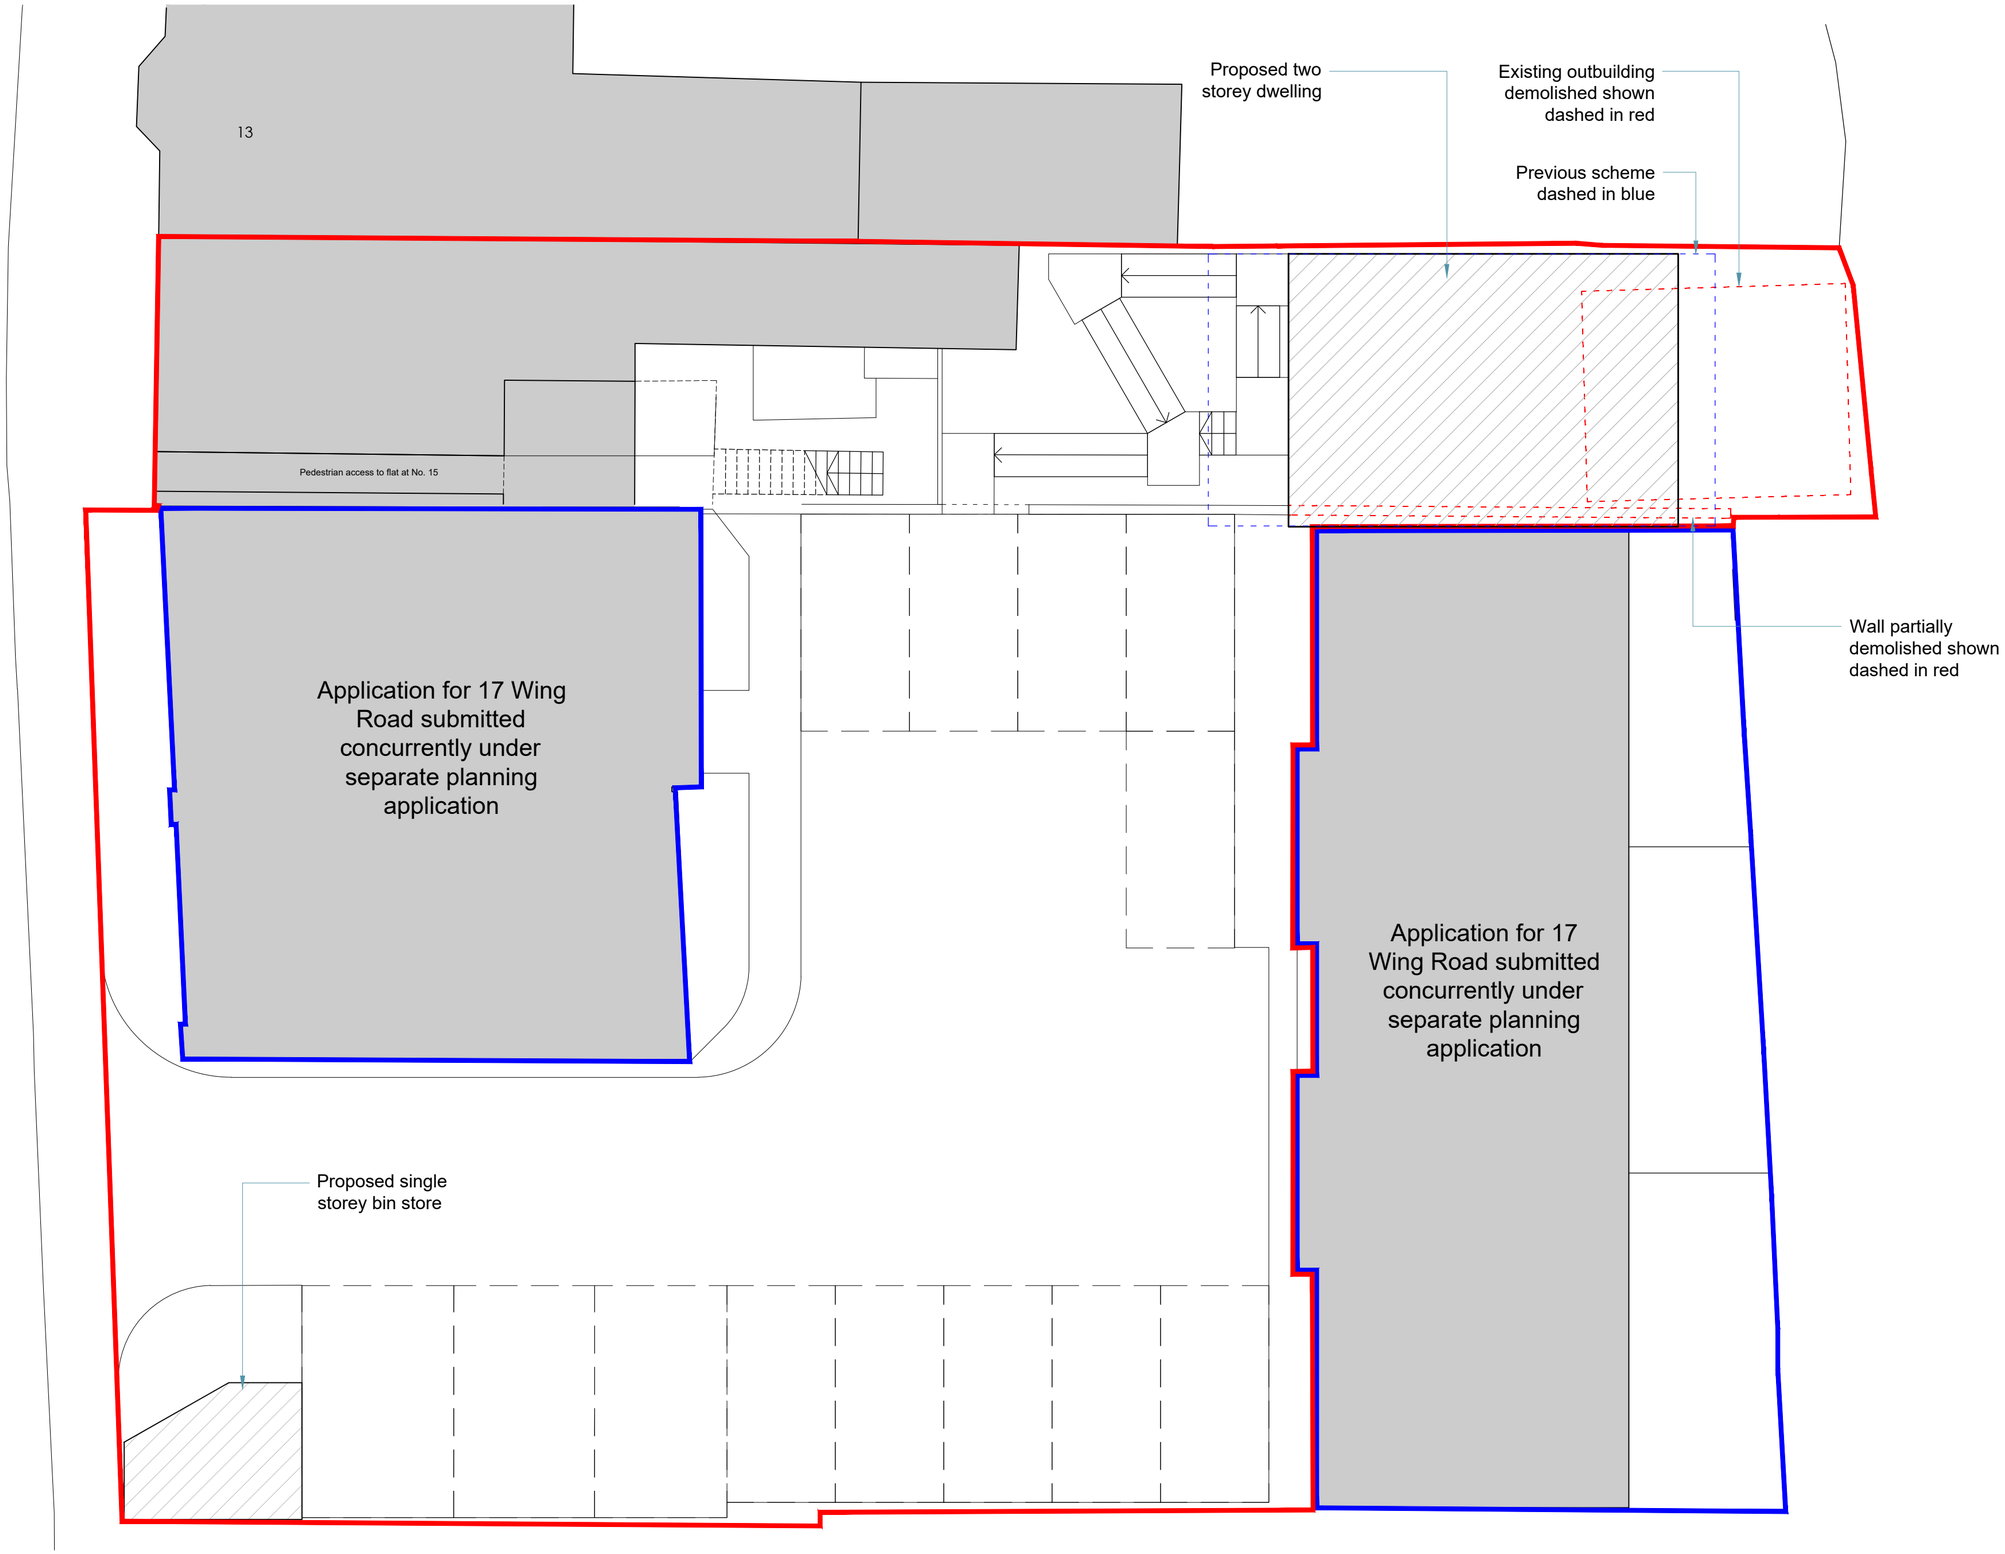

Notes:

All dimensions are to structural elements/openings, not finished surface, unless otherwise stated.

Rev	Date	Details	Drawn	Checked
04	22.02.2022	Red line adjusted around building at No. 17 for clarity	PCD	AA
03	05.01.2022	Revised planning drawing issue	PCD	CFG
02	10.08.2021	Car park and bin store updated	AA	CFG
01	06.07.2021	Issued for Planning	AA	CFG

SCROXTON & PARTNERS

Northampton - 01933 698 001
northampton@scroxtonandpartners.co.uk

London - 0203 745 8018
london@scroxtonandpartners.co.uk

Client:
Ashbolt Ltd

Project Name:
15 Wing Road

Site Address:
15 Wing Road, Linslade
Leighton Buzzard
LU7 2NG

Drawing Number: 1343 SAP XX 00 DR A 10020 S0
Revision: 04

Drawing Title: Proposed Block Plan
Volume: XX

Project Lead: CFG
Stage: 03
Project Phase: Planning

Scale: 1:100
Paper: A2
1m 2m 3m 4m

Only figured dimensions are to be taken from this drawing. All dimensions are to be checked on site before any work is put in hand. If in doubt, ask. This drawing must be read in conjunction with all other relevant project drawings, schedules and specifications as listed on the most recent Scroxton & Partners drawing issue sheet. This drawing may not be copied in whole or in part without prior written permission from one of the Scroxton & Partners team. Attempting to use any information supplied by Scroxton & Partners for purposes other than that agreed may incur further fees or legal action. © Copyright Scroxton & Partners